
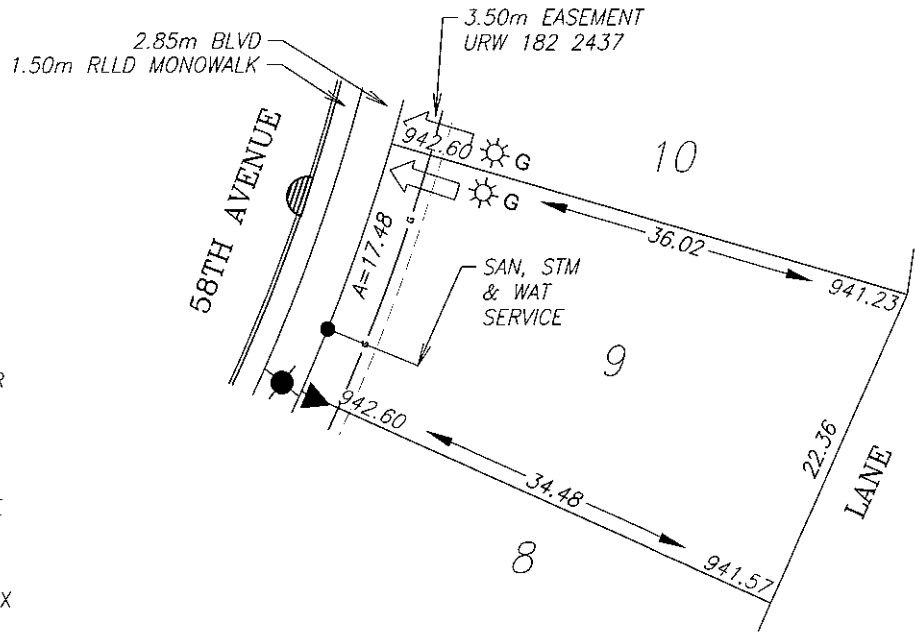
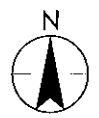


# BUILDING GRADE CERTIFICATE

Town of Innisfail  
 Issued by: No.

1. WHEN EXCAVATING IN A RIGHT OF WAY (EASEMENT), CHECK FOR UTILITIES.
2. STANDING AT THE WATER SHUTOFF AND FACING THE BUILDING, THE SANITARY SERVICE (PAINTED RED) IS ON THE RIGHT SIDE OF THE WATER SERVICE; STORM SERVICE (PAINTED GREEN) IS ON THE LEFT SIDE OF THE WATER SERVICE.
3. ALL DIMENSIONS ARE IN METRES AND DECIMALS THERE OF. THE ELEVATIONS ARE IN METRES ABOVE GEODETIC MEAN SEA LEVEL.
4. ELEVATIONS NOTED ON THE CERTIFICATE ARE WITHIN 100mm OF ACTUAL.
5. THE BUILDER MUST CONSTRUCT WITHIN 100mm OF THE DESIGN LANDSCAPE ELEVATION & ILLUSTRATED DRAINAGE PATTERNS UNLESS OTHERWISE APPROVED BY THE DEVELOPMENT OFFICER.
6. IF THE INFORMATION ON THIS CERTIFICATE HAS BEEN PREPARED BY A PRIVATE DEVELOPER OR THEIR AGENT, THE TOWN OF INNISFAIL ACCEPTS NO RESPONSIBILITY FOR ITS ACCURACY.

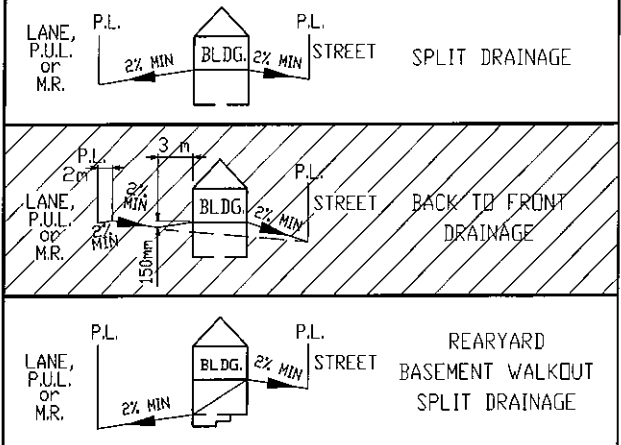

**LEGEND**

- SAN, STM & WATER
- ⊗ FIRE HYDRANT
- ⊙ CATCH BASIN
- ⊙ GAS
- ⊙ POWER, TELEPHONE & CABLE SERVICE
- ⊙ STREET LIGHT
- ⊗ COMMUNITY MAILBOX
- TRANSFORMER
- ▲ PEDESTAL
- G GAS SERVICE
- ➔ DRIVEWAY

GAS SERVICE LOCATION IS 0.7m FROM SIDEYARD LOTLINE  
 POWER SERVICE LOCATION IS 1.00m FROM SIDEYARD LOTLINE  
 SANITARY, STORM AND WATER SERVICE LOCATION IS 4.50m FROM SIDEYARD LOTLINE  
 SHALLOW STORM SERVICE IS REQUIRED

TOP OF FOOTING: MAX. DEPTH BELOW AVERAGE SIDEWALK = 1.93 LOWEST ELEVATION = 940.67	CIVIC ADDRESS: 6608 58TH AVENUE LOT: 9 BLOCK: 10 PLAN No.: 182 2436 DEVELOPER: HAZELWOOD ESTATES INC. SCALE: 1:500 DRAWN BY: SPANTEC CONSULTING LTD. DATE: SEP 24, 2018 APPROVED BY: TRAVIS HELLER, P.ENG DATE: SEP 24, 2018 RECEIVED BY: DATE:
AS-BUILT SEWER INVERT ELEVATIONS: SANITARY AT 6.5m INSIDE LOT = 939.82 STORM AT 6.5m INSIDE LOT = 941.16	

DESIGN LANDSCAPE ELEVATIONS ELEV. AT FRONT OF HOUSE = 942.90 ELEV. AT REAR OF HOUSE = 941.87	I CERTIFY THAT THE FINAL LANDSCAPE GRADE WILL BE (FRONT) _____ (REAR) _____ SIGNATURE OF OWNER OR REPRESENTATIVE _____
--	--