
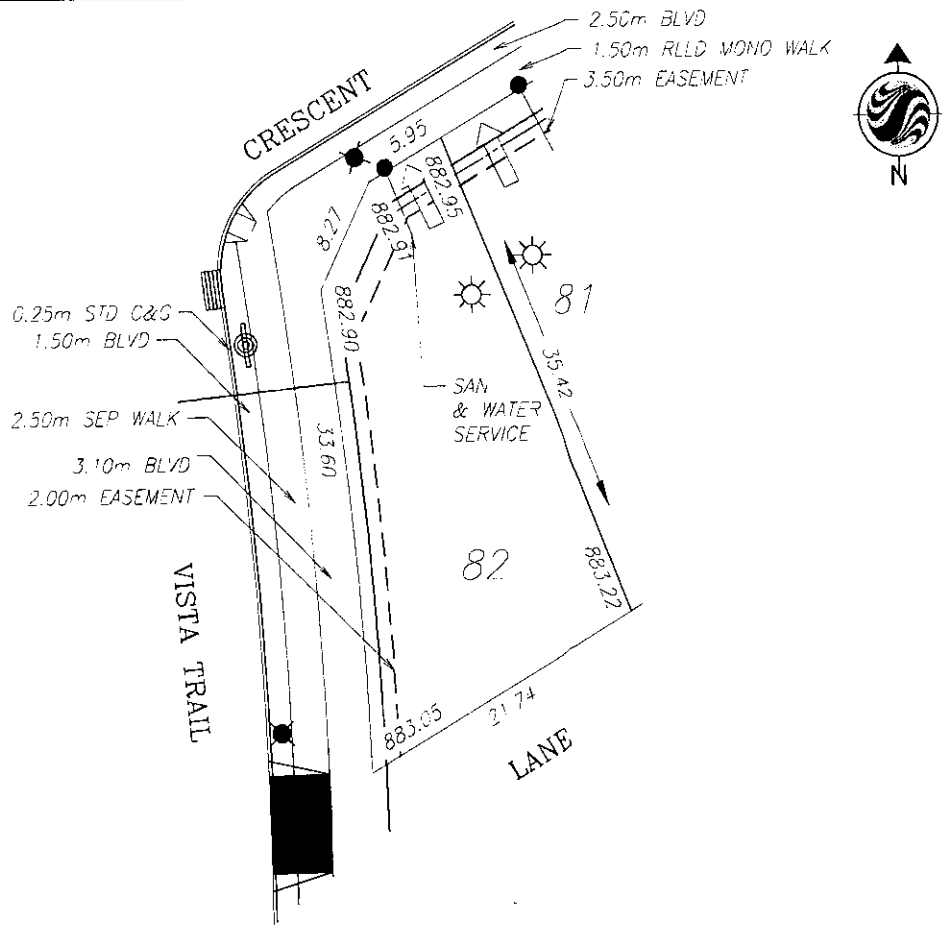
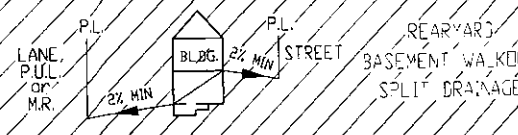
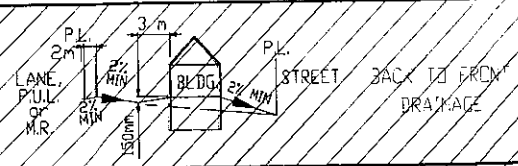


BUILDING GRADE CERTIFICATE

Town of Blackfalds
 Issued by: No.

1. WHEN EXCAVATING IN A RIGHT OF WAY (EASEMENT), CHECK FOR UTILITIES.
2. STANDING AT THE WATER SHUTOFF AND FACING THE BUILDING, THE SANITARY SERVICE (PAINTED RED) IS ON THE LEFT SIDE OF THE WATER SERVICE.
3. ALL DIMENSIONS ARE IN METRES AND DECIMALS THERE OF. THE ELEVATIONS ARE IN METRES ABOVE GEODETIC MEAN SEA LEVEL.
4. ELEVATIONS NOTED ON THE CERTIFICATE ARE WITHIN 100mm OF ACTUAL.
5. THE BUILDER MUST CONSTRUCT WITHIN 100mm OF THE DESIGN LANDSCAPE ELEVATION & ILLUSTRATED DRAINAGE PATTERNS UNLESS OTHERWISE APPROVED BY THE DEVELOPMENT OFFICER.
6. IF THE INFORMATION ON THIS CERTIFICATE HAS BEEN PREPARED BY A PRIVATE DEVELOPER OR THEIR AGENT, THE TOWN OF BLACKFALDS ACCEPTS NO RESPONSIBILITY FOR ITS ACCURACY.

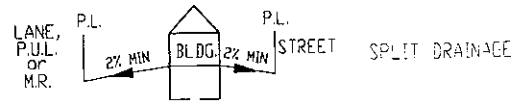

LEGEND

- SAN & WATER
- ⊙ FIRE HYDRANT
- o- GAS
- ☀ POWER, TELEPHONE & CABLE SERVICE
- STREET LIGHT
- ⊠ COMMUNITY MAILBOX
- POWER TRANSFORMER
- CABLE PEDESTAL
- ▲ TELEPHONE PEDESTAL
- 3 PARTY PEDESTAL
- ➡ DRIVEWAY

LOWEST TOP OF FOOTING DETERMINED BY SANITARY SERVICE. SUMP PUMP MAY BE REQUIRED.
 GAS AND POWER SERVICE LOCATION IS 1.50m FROM SIDEYARD LOTLINE.
 SANITARY, STORM & WATER SERVICE LOCATION IS 4.50m FROM SIDEYARD LOTLINE.

TOP OF FOOTING:	
MAX. DEPTH BELOW AVERAGE SIDEWALK =	2.11
LOWEST ELEVATION =	880.81
AS-BUILT SEWER INVERT ELEVATIONS:	
SANITARY AT 5.0m INSIDE LOT =	879.96
STORM AT 5.0m INSIDE LOT =	--

CIVIC ADDRESS:	81 VERMONT CLOSE		
LOT:	82	BLOCK:	3
PLAN No.:			
DEVELOPER:	MALIBU COMMUNITIES LTD.	SCALE:	1:500
DRAWN BY:	STANTEC CONSULTING LTD	DATE:	AUG 14, 2012
APPROVED BY:	ALAN FORMAN, P.ENG	DATE:	JAN 13, 2013
RECEIVED BY:	NAME	DATE:	-

DESIGN LANDSCAPE ELEVATIONS	
ELEV. AT FRONT OF HOUSE =	883.29
ELEV. AT REAR OF HOUSE =	883.56

I CERTIFY THAT THE FINAL LANDSCAPE GRADE WILL BE (FRONT) _____
 (REAR) _____
 SIGNATURE OF OWNER OR REPRESENTATIVE _____